


# MONUMENT RECORD

Corner ID: **Per\_E09**



## Section Corner

Sections 07, 08, 17 & 18- T08N-R01W, 2nd P.M.

Perry Township, Monroe County, Indiana

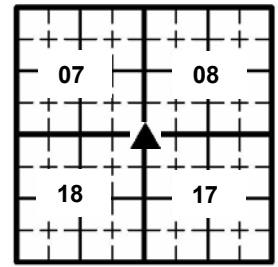

**MONUMENT:** Describe monument set or found (Include material type, scribing, distance above/below grade, dimensions.)  
Mag Nail found 0.1' below grade

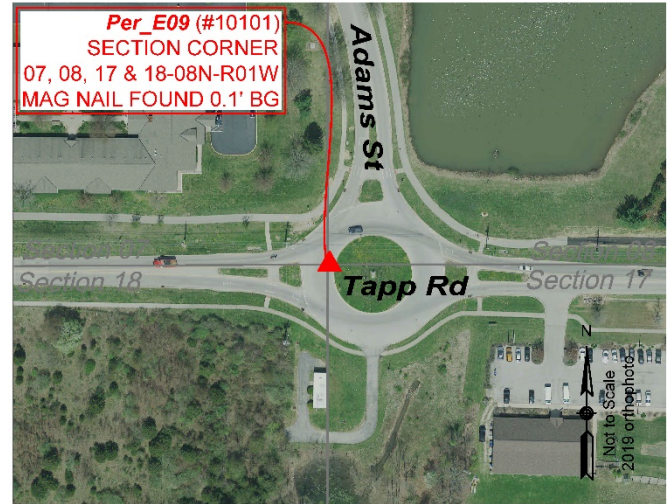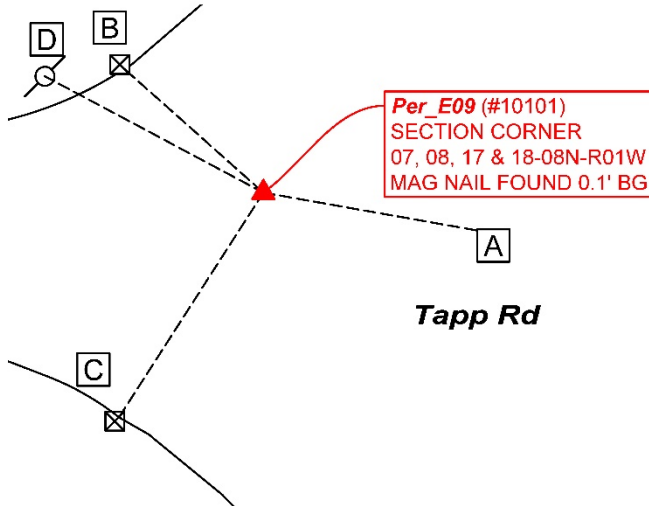

### WITNESS MONUMENT TIES

All ties to new Bearing Trees (BTs) are a mag nail set in a 1-1/2" plastic washer stamped "SURVEY MARKER - DO NOT REMOVE" and hack mark at the root crown (less than 12" above ground) perpendicular to the center of the tree, unless otherwise noted. BT diameters are noted as dbh and are measured approximately 4.5' above ground. Bearings are measured from the monument to the center of the BT, distances are measured from the monument to the mag nail.

ID	BEARING	DISTANCE	DESCRIPTION
Witness A	S 80d E	45.6'	Top northwest corner of 3'X6' limestone sculpture base located in center of circle
Witness B	N 48d W	39.3'	Cut "X" northwest corner on backside of curb water inlet northwest of monument
Witness C	S 33d W	56.2'	Cut "X" northwest corner on backside of curb water inlet southwest of monument
Witness D	N 62d0'0" W	52.3'	Survey sign set 4.25' above grade southeast side. Mag nail set 0.75' southeast side on 12" utility pole 768212.



OFFICE OF THE MONROE COUNTY SURVEYOR • Trohn Enright-Randolph

119 W 7th Street, Bloomington, IN 47404 • 812-349-2570 • surveyoroffice@co.monroe.in.us

Page 1 of 3


# MONUMENT RECORD

Corner ID: **Per\_E09**

## Section Corner

Sections 07, 08, 17 & 18- T08N-R01W, 2nd P.M.

Perry Township, Monroe County, Indiana

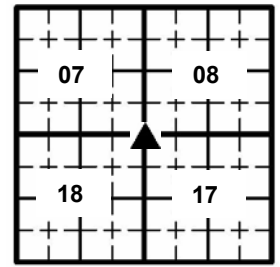

**PHOTO IDENTIFIED:** *Photo Date:* 09/30/2021



*Photo Orientation & Description:* Per\_E09 from above



*Photo Orientation & Description:* Looking west at Per\_E09



*Photo Orientation & Description:* Looking east at Per\_E09



*Photo Orientation & Description:* Looking north at Per\_E09



*Photo Orientation & Description:* Looking south at Per\_E09



**OFFICE OF THE MONROE COUNTY SURVEYOR • Trohn Enright-Randolph**

119 W 7th Street, Bloomington, IN 47404 • 812-349-2570 • [surveyorsoffice@co.monroe.in.us](mailto:surveyorsoffice@co.monroe.in.us)




# MONUMENT RECORD

Corner ID: **Per\_E09**

## Section Corner

Sections 07, 08, 17 & 18- T08N-R01W, 2nd P.M.

Perry Township, Monroe County, Indiana

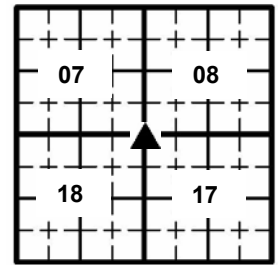

**EXISTING SURVEY HISTORY** *Include as much detail and history of the corner as known at the time of perpetuation*

**ORIGINAL OR SUBSEQUENT SURVEY EVIDENCE FOUND:** *Include, search area or areas, search procedure, etc.*

Date of Field work/Search: 09/30/2021 By: RSO, TER, JG Monument Found: Mag Nail BTs or Reference Objects Found: Witness D Mag Nail in pole from 12/04/2006 Project #: Per\_C09 Field Book: 54/35 Equipment: : The basis of bearings is Grid North System NAD83(2011)/Indiana West NAVD 88, Epoch 2010.0000, geoid12b\_conus.db3, US Survey Feet, derived from GPS observations utilizing the Indiana Real-Time Network (INCORS). Coordinate data was collected with a Javad Triumph LS Network Rover. Coordinates are available upon request. Distances to Witness A, B & C were calculated by points gathered with the Javad Triumph LS Network Rover. Distance to Witness D was measured with a tape measure. Bearings to witness ties were collected with the internal magnetic compass of the Javad Triumph LS and were automatically adjusted to grid north and are approximately shown hereon for reference. Priority should be given to provided distances over bearings. Notes: All witness photos on file in the Monroe County Surveyors Office.

**OTHER EVIDENCE:** *Describe corner location relative to nearby features and how to reach the corner location – note fences, roads, timber cutting lines, mow lines, clearings, plantings, streams, topo changes, etc.*

Monument is located in the northwest sector of a roundabout intersecting Tapp Rd and Adams St

**MONUMENT PRESERVATION:** *Describe work done to preserve existing monument.*

Witness D was replaced with another mag nail. "Protect Nearby Survey Marker" sign nailed to southeast side of 12" utility pole 768212 4.25 feet above grade.

**THEORY OF LOCATION:** *Describe the theory of location for acceptance of this monument. Include monument origin and associated uncertainty.*

The MAG nail was previously witnessed by the Monroe County Surveyor, Kevin Enright, on October 30, 2006 and accepted by the Monroe County Surveyor Review Board on December 12, 2006. The 2006 Monument Record accepted the MAG nail per a plat of survey by Kevin B. Potter recorded as Instrument Number 417041 for B.G. Hoadley Quarries, Inc. The 2006 Monument Record accepted the MAG nail per a 2006 Bynum Fanyo survey, Location Plat on file in the Surveyor's Office, RSID004122. References on File: Ben Bledsoe survey, Sudbury Property (2014) on file in the Records Office 2014004467.IN. Historic research has not yet been performed to prove the validity of this monument.

### CERTIFICATION:



Date: 12/09/2021  
Trohn Enright-Randolph  
Monroe County Surveyor



Accepted by the Monroe  
County Surveyor Review  
Board on date: 12/09/2021



**OFFICE OF THE MONROE COUNTY SURVEYOR • Trohn Enright-Randolph**

119 W 7th Street, Bloomington, IN 47404 • 812-349-2570 • surveyoroffice@co.monroe.in.us

MONUMENT RECORD  
State of Indiana - County of Monroe

Section: 7

Township: 8 North


Range: 1 West

Corner ID: Per E-09

**Monument Description & Remarks:** MAG nail set. Survey Sign 6ft above ground at pt. (B).

**References On File:** Kevin B. Potter survey, B.G. Hoadley Quarries, Inc. (1994); Bynum Fanyo survey, Location Plat (2006), on file in Surveyor Office.

RECOVERY TIE DRAWING  
Field Book 38 Page No. 47

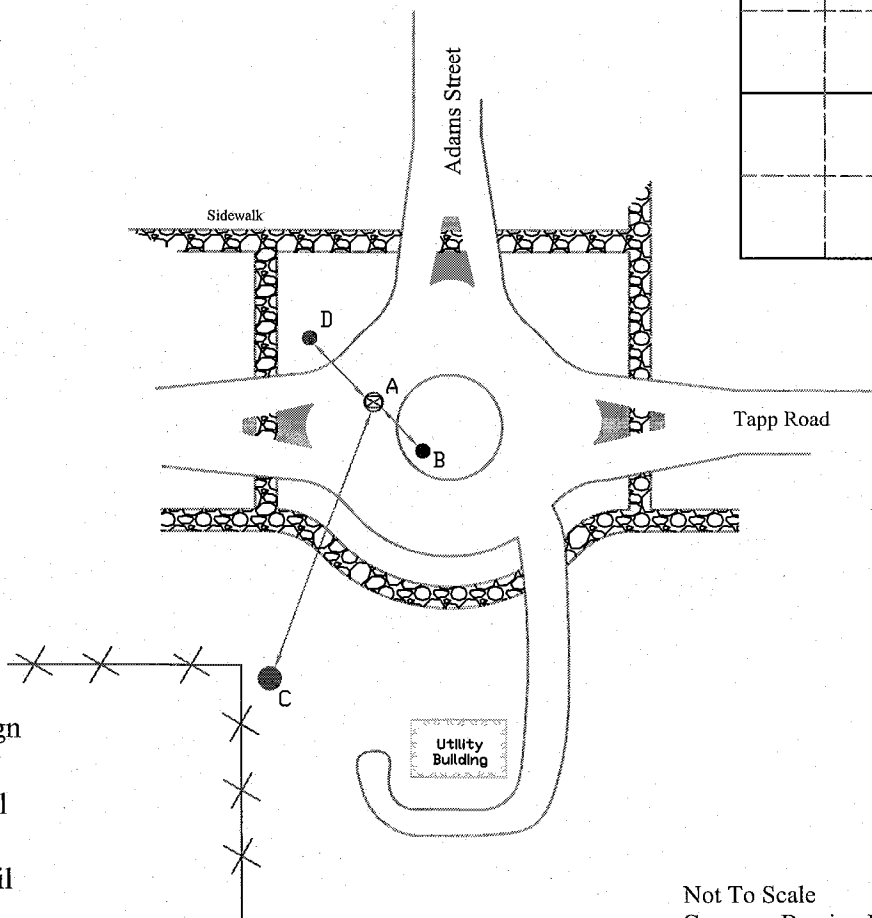

A - MAG nail


B - S 17° E 27.55' to Survey Sign  
on a One Way sign post

C - S 34° W 52.26' to MAG nail  
in 14" power line pole

D - N 62° W 96.05' to MAG nail  
in 14" power line pole

Not To Scale  
Compass Bearing Magnetic North

I, Kevin P. Enright, Monroe County Surveyor, hereby certify that this document was prepared under my direction in accordance with the provisions of section 36-12-11 of the Indiana Code; and the above data is given under my hand and seal this 30th day of October, 2006.

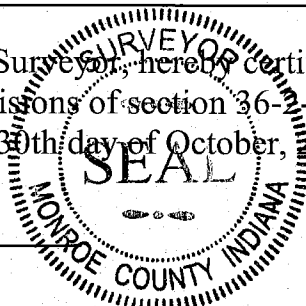

Administered by the Monroe County Surveyor Review Board

Date: 12/12/06

